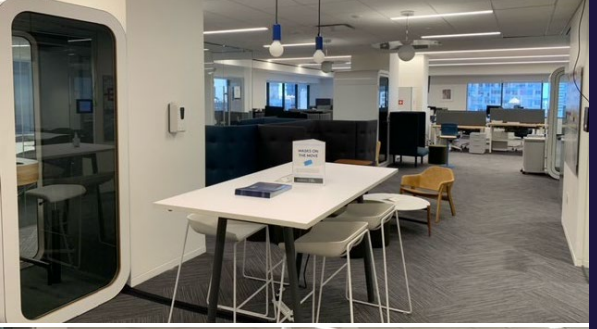

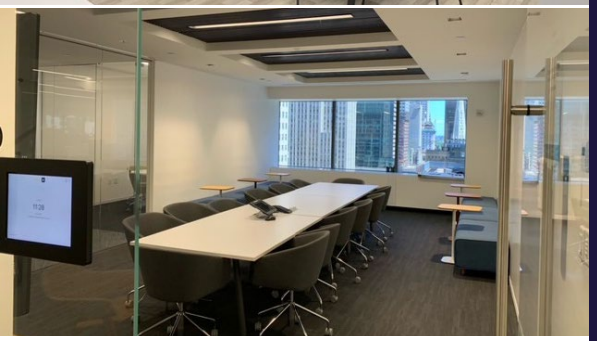

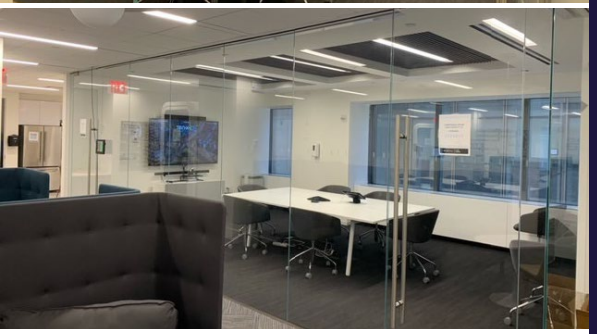

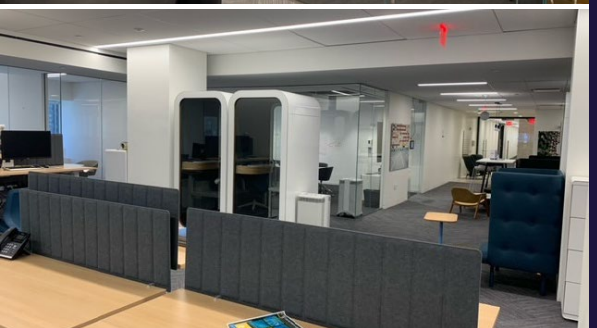

575 FIFTH | P20

8,648 RSF

- Planned lobby renovation
- Existing amenity center to be renovated and expanded
- Additional amenities planned
- High-end built units
- Central Park views North

As-Built

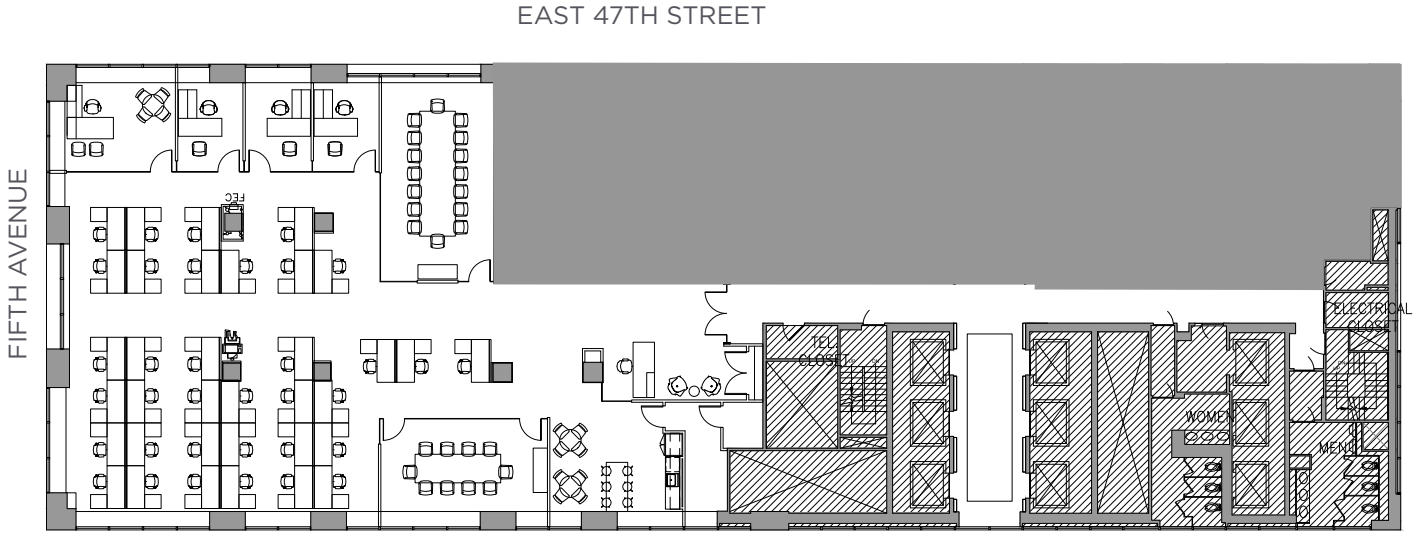

Michael Movshovich
+1 212 841 7905
michael.movshovich@cushwake.com

Anthony LoPresti
+1 212 841 7701
anthony.lopresti@cushwake.com

Eric Hazen
+1 212 841 7809
eric.hazen@cushwake.com

Connor Daugstrup
+1 212 841 7964
connor.daugstrup@cushwake.com

©2026 Cushman & Wakefield. All rights reserved. The information contained in this communication is strictly confidential. This information has been obtained from sources believed to be reliable but has not been verified. NO WARRANTY OR REPRESENTATION, EXPRESS OR IMPLIED, IS MADE AS TO THE CONDITION OF THE PROPERTY (OR PROPERTIES) REFERENCED HEREIN OR AS TO THE ACCURACY OR COMPLETENESS OF THE INFORMATION CONTAINED HEREIN, AND SAME IS SUBMITTED SUBJECT TO ERRORS, OMISSIONS, CHANGE OF PRICE, RENTAL OR OTHER CONDITIONS, WITHDRAWAL WITHOUT NOTICE, AND TO ANY SPECIAL LISTING CONDITIONS IMPOSED BY THE PROPERTY OWNER(S). ANY PROJECTIONS, OPINIONS OR ESTIMATES ARE SUBJECT TO UNCERTAINTY AND DO NOT SIGNIFY CURRENT OR FUTURE PROPERTY PERFORMANCE. PD-180691

CUSHMAN & WAKEFIELD